



BID NO.:617	PROJECT NAME & LOCATION	New York City College of Technology New Academic Building 285 Jay Street Brooklyn, New York
Description: Furnish, Deliver and Install Lockers		
Bid Open Location: DASNY		
	515 Broadway, Albany, New York	
York Bid Open Date: October 4, 2018		
Bid Open Time: 2:30 p.m.	Contact: Kristen Costello	(518) 257-3119

NOTICE TO BIDDERS

MAIL BIDS EARLY

Sealed bids will be received by DASNY at the above address for the items listed in the attached Bid Breakdown and Schedule. When submitting your bid you must:

1. Prepare your bid on the attached Bid Breakdown and Schedule. Return one signed original of the Bid Breakdown and Schedule
2. If your bid deviates from Specifications, explain such deviations or qualifications on your letterhead, setting forth therein such explanations, and attach them to the Bid Breakdown and Schedule.
3. Submission of a bid constitutes full knowledge and acceptance of all provisions of the Notice to Bidders, all information referenced in the Purchasing General Conditions, Supplemental and Detailed Specifications, the Bid Submission and any Supplemental General Requirements contained herein, as well as any addenda issued in relation to the Invitation for Bids.
4. Each bid shall bear on the outside of the envelope the name of the bidder, address, telephone number and designated as a bid for the following:
DASNY Bid No. 617 - Furnish, Deliver and Install Lockers
Bid Opening Date: October 4, 2018 @ 2:30PM
Return to:
DASNY
Attn: Purchasing Unit
515 Broadway
Albany, NY 12207-2964



Bid No.: 617

When a sealed bid is placed inside another delivery jacket, the bid delivery jacket must be clearly marked on the outside “**BID ENCLOSED**” and “**ATTENTION: PURCHASING UNIT**”. The Dormitory Authority will not be responsible for receipt of bids which do not comply with these instructions.

5. Mail bid responses early in order for them to be received before the time of the bid opening. **Late bids will be automatically rejected.** Individuals submitting bids in person or by private delivery services should allow sufficient time for processing through building security to assure that the bids are received prior to the deadline for submitting bids. All individuals who plan to attend bid openings will be required to present government-issued picture identification to building security officials and obtain a visitor’s pass prior to attending the bid opening.

6. In accordance with State Finance Law § 139-j and 139-k, this solicitation includes and imposes certain restrictions on communications between Dormitory Authority personnel and an Offerer during this procurement process. Designated contact for this solicitation is: Kristen Costello, Sr. Purchasing Coordinator , at Dormitory Authority – State of New York, 515 Broadway, Albany, NY 12207,(518) 257-3119. Contacts made to other Dormitory Authority Personnel regarding this procurement may disqualify the Offerer and affect future procurements with governmental entities in the State of New York. Please refer to the Authority’s website www.dasny.org for Authority policy and procedures regarding this law, or the NYS office of General Services website www.ogs.ny.gov/BU/PC/ for more information about this law.



Bid No.: 616

If you are not submitting a bid it is requested that you complete and return the lower portion of this form

(Please check all that apply and provide comments in the space provided, if necessary)

- We are not Submitting a bid.
- We Request removal of our name from the mailing list.
- Location of the job site.
- Commodity is not carried by our company.
- Scope is too large.

Other/Additional Explanation: _____

NAME OF BIDDER: _____

ADDRESS : _____

Street Telephone	City	State	Zip
------------------	------	-------	-----

Signature of Bidder

Official Title

CLAUSES PURSUANT TO THE OMNIBUS PROCUREMENT ACT OF 1992

It is the policy of New York State to maximize opportunities for the participation of New York State business enterprises, including minority and woman-owned business enterprises as bidders, subcontractors and suppliers on its procurement contracts.

Information on the availability of New York subcontractors and supplies is available from:

Empire State Development
Small Business Division
30 South Pearl Street, 7th Floor
Albany, NY 12207
Phone: (800) 782-8369

A directory of minority and woman-owned business enterprises is available from:

Empire State Development
Division of Minority and Women Business Development
30 South Pearl Street
Albany, NY 12207
Phone: (518) 292-5250

Online Directory: <https://ny.newnycontracts.com/FrontEnd/VendorSearchPublic.asp>

[DASNY maintains a directory of minority and women-owned business enterprises:
http://www.dasny.org/construc/mwsberreg/index.php](http://www.dasny.org/construc/mwsberreg/index.php)

The contractor acknowledges notice that New York State may seek to obtain offset credits from foreign countries as a result of this contract and agrees to cooperate with the State in these efforts.

DASNY encourages the use of recycled Materials in the manufacturing process. To that end, the recycled product must meet the same codes, specifications and standards the non-recycled materials do, including requirements for cost, installation, aesthetics, availability and maintenance.

The Omnibus Procurement Act of 1992 and § 2879 of the NYS Public Authorities Law require that by signing this bid, contractors certify that whenever the total bid amount is greater than \$1 million:

1. The contractor has made reasonable efforts to encourage the participation of New York State Business Enterprises as suppliers and Subcontractors on this project, and has retained the documentation of these efforts to be provided upon request to the State. If the contractor determines that NYS business enterprises are not available to participate on the contract as subcontractors or suppliers, the contractor shall provide a statement indicating the method by which such determination was made. If the contractor does not intend to use subcontractors, contractor shall provide a statement verifying such;
2. The contractor has complied with the Federal Equal Opportunity Act of 1972 (PL 92-261), as amended;
3. The contractor agrees to make reasonable efforts to provide notification to New York State residents of employment opportunities on this project through listing any such positions with the Job Service Division of the New York State Department of Labor, or providing such notification in such manner as is consistent with existing collective bargaining contracts or agreements. The contractor agrees to document these efforts and to provide said documentation to the State upon request;

DASNY is required by law to notify the NYS Department of Economic Development of any procurement contract for one million dollars or more that is to be awarded to an out-of-state vendor. This notice must be done simultaneous to the notification of award provided to the vendor. A purchase order or contract cannot be issued until fifteen (15) days after such notification is provided.



DASNY

GENERAL SPECIFICATIONS

- (1) The enclosed Purchasing General Conditions are hereby incorporated by reference. Submission of a bid response shall constitute acceptance of such conditions. Any exceptions/clarifications/qualifications to these conditions or other specifications and/or requirements contained herein must be clearly stated in the bid response and, depending upon the nature of such, may be grounds for rejection of your bid.
- (2) Bids must be submitted in the bidder's full legal name, or the bidder's full legal name plus a registered assumed name, if any.
- (3) All NYS bidders are required to be registered to do business with the NYS Department of State or their local County Clerk, whichever is applicable.
- (4) All out-of-state bidders will be required to provide proof of registration to do business in their state. All out-of-state bidders that "do business in New York State" **MUST BE REGISTERED WITH THE NYS DEPARTMENT OF STATE**. Please contact the NYS Department of State at (518) 473-2492. Information is available at the DOS website: www.dos.ny.gov
- (5) DASNY is required by law to notify the Empire State Development of any procurement contract for one million dollars or more that is to be awarded to an out-of-state vendor. This notice must be done simultaneous to the notification of award provided to the vendor. A purchase order or contract cannot be issued until fifteen (15) days after such notification is provided.
- (6) Empire State Development is required by law to identify states and other jurisdictions that impose preferences or other penalties against New York bidders. DASNY is precluded from soliciting bids or entering into procurement contracts with companies that have their principal place of business located in one of the listed jurisdictions, unless the procurement is for a product that is substantially manufactured in New York State or the services are to be performed in New York State. Currently, this list of jurisdictions includes the states of Alaska, Hawaii, Louisiana, South Carolina, West Virginia and Wyoming.
- (7) Unless otherwise indicated, any reference to brands or model numbers is intended to establish a standard. Items of all manufacturers will be considered, provided the item is determined to meet or exceed the required specification. DASNY's decision as to whether a substitute item meets specification will be final. Your attention is directed to Article II-7, Page 5 of the General Conditions. In order to evaluate substitute items, detailed specifications must be submitted for any product that is other than the one(s) specified in the bid.



DASNY

GENERAL SPECIFICATIONS CONTINUED

- (8) Unless otherwise noted, guarantee on all items is to be one year as detailed in Article XVI of the General Conditions
- (9) All upholstered furniture and drapery panels and lining must meet strict flammability requirements. Standards applicable to this bid, if any, will be delineated in the Detailed Specifications.
- (10) LABOR/TRADES - Any labor, materials or means whose employment, or utilization during the course of this contract, shall not in any way cause or result in strike, work stoppages, delays, suspension of work; or similar troubles by workers employed by this contractor or his subcontractors, or by any of the trades working in or about the buildings and premises where work is being performed. Any violation by the contractor of this requirement may in the sole judgment of DASNY be considered as proper and sufficient cause for declaring the contractor to be in default, and for the owner to take action against him as set forth in the Purchasing General Conditions, Article VIII, "Termination", or such other action as DASNY may deem proper.
- (11) Bid results are available on the DASNY website (www.DASNY.org). Bid results will not be given over the phone.
- (12) If you are a NYS Certified Minority or Women Owned Business, please include a copy of your certification with the bid.



DASNY

ANDREW M. CUOMO
Governor

ALFONSO L. CARNEY, JR.
Chair

GERRARD P. BUSHELL, Ph.D.
President & CEO

SUPPLEMENTAL SPECIFICATIONS

The following items are attached for informational purposes. Referenced documents need not be returned with the proposal. These documents are only applicable to the successful bidder and the ensuing procurement contract. Documents are only applicable to the successful bidder and the ensuing procurement contract. Documents applicable to the procurement that will result from this Invitation for Bids are designated by a check box (☒). Unless otherwise indicated, the referenced documents are located at the end of this Invitation for Bids.

- ☒ **Purchasing General Conditions** – The DASNY Purchasing General Conditions contains terms and conditions of purchases made by DASNY. It is recommended that this document be reviewed fully.
- ☒ **M/WBE Utilization Plan and Request for Waiver** - Minority and Women-Owned Business Enterprise (M/WBE) goals for this project are 15% and 15%, respectively. The successful bidder shall be required to complete a Utilization Plan or Request for Waiver, to be approved by DASNY’s Opportunity Programs Group. Reference Purchasing General Conditions, Article XIX, Affirmative Action for Contracts Mr. Michael Clay, DASNY Opportunity Programs Group at (518) 257-3464, is available to assist all bidders in attaining these goals. *Reference the enclosed “Good Faith Efforts Guidelines”.*
- ☒ **Supplemental General Requirements** – Attached (if applicable) are the Supplemental General Requirements (SGRs) which provide important logistical information and additional conditions which govern this procurement. Please read these SGRs carefully.
- ☒ **Form of DASNY Contract** – The procurement resulting from the Invitation for Bids will be executed through a DASNY purchase order and a related contract. The contract executed with the successful bidder will be in the same substantial form as the attached “Form of Contract”. Note that this Invitation for Bids and any response to such will be annexed as binding terms of the purchase agreement.
- ☒ **Certificate of Insurance** (*sample enclosed*) – The successful bidder will be required to provide a Certificate of Insurance pursuant to Article XIV of the enclosed Purchasing General Conditions. The certificate shall name DASNY and other designated parties as additional insureds.

CORPORATE HEADQUARTERS
515 Broadway
Albany, NY 12207-2964

T 518-257-3000
F 518-257-3100

NEW YORK CITY OFFICE
One Penn Plaza, 52nd Floor
New York, NY 10119-0098

T 212-273-5000
F 212-273-5121

BUFFALO OFFICE
539 Franklin Street
Buffalo, NY 14202-1109

T 716-884-9780
F 716-884-9787

DORMITORY AUTHORITY STATE OF NEW YORK

**WE FINANCE, BUILD AND
DELIVER.**

www.dasny.org



DASNY

ANDREW M. CUOMO
Governor

ALFONSO L. CARNEY, JR.
Chair

GERRARD P. BUSHELL, Ph.D.
President & CEO

SUPPLEMENTAL SPECIFICATIONS CONTINUED

- Worker’s Compensation / Disability Insurance** – The successful proposer will be required to provide specific documentation with respect to Worker’s Compensation and Disability Insurance pursuant to Article XIV of the enclosed Purchasing General Conditions. Requirements are detailed in the enclosed “Workers’ Compensation and Disability Benefits Requirements” document.

- Prevailing Wage Schedule** – NYS Labor Law requires all wages paid by contractors and subcontractors on public work projects be paid at the prevailing wage rates. Enclosed is the current rate schedule for the appropriate county. Contractors and Subcontractors are responsible for obtaining current rates throughout the course of the project. The NYS Department of Labor (NYS DOL) updates these rates on July 1st of each year. Current rates can be obtained on the NYS DOL website (www.labor.state.ny.us) or by fax at (518) 485-1870. Note that an executed Contractor and Subcontractor Certification and certified payrolls, which include the hours and days worked by each workman, laborer or mechanic, the occupation at which he worked, the hourly wage rate paid and the supplements paid or provided, must be submitted with each and every payment requisition. **DASNY will not process an invoice without this information.** Forms are available on the DASNY website:
<http://www.dasny.org/construc/forms2/vendors.php>

- Labor and Material Payment Bond** – The successful bidder must be prepared to provide surety bonds prior to award in accordance with Article XIV of the DASNY Purchasing General Conditions. The costs of these bonds are to be separately stated in the total bid price as indicated on the Bid Breakdown and Schedule.

- Performance Bond** – The Successful bidder must be prepared to provide surety bonds prior to award in accordance with Article XIV of DASNY Purchasing General Conditions. The costs of these bonds are to be separately stated in the total bid price as indicated on the Bid Breakdown and Schedule.

- Standard Vendor Responsibility Questionnaire (SVRQ)** – The successful proposer, in accordance with Article XXII of DASNY Purchasing General Conditions, will be required to complete the enclosed SVRQ. The award of a contract will be subject to a review of the information contained in these forms.

CORPORATE HEADQUARTERS
515 Broadway
Albany, NY 12207-2964

NEW YORK CITY OFFICE
One Penn Plaza, 52nd Floor
New York, NY 10119-0098

BUFFALO OFFICE
539 Franklin Street
Buffalo, NY 14202-1109

DORMITORY AUTHORITY STATE OF NEW YORK

WE FINANCE, BUILD AND DELIVER.

T 518-257-3000
F 518-257-3100

T 212-273-5000
F 212-273-5121

T 716-884-9780
F 716-884-9787

www.dasny.org



DASNY

ANDREW M. CUOMO
Governor

ALFONSO L. CARNEY, JR.
Chair

GERRARD P. BUSHELL, Ph.D.
President & CEO

SUPPLEMENTAL SPECIFICATIONS CONTINUED

- NYS Uniform Contracting Questionnaire (UCQ)** – The successful proposer will be required to complete the enclosed UCQ. The award of a contract will be subject to a review of the information contained in these forms.

- DASNY Contractor and Consultant Questionnaire (CCQ)** – The successful proposer will be required to complete the enclosed CCQ. The award of a contract will be subject to a review of the information contained in these

CORPORATE HEADQUARTERS
515 Broadway
Albany, NY 12207-2964

T 518-257-3000
F 518-257-3100

NEW YORK CITY OFFICE
One Penn Plaza, 52nd Floor
New York, NY 10119-0098

T 212-273-5000
F 212-273-5121

BUFFALO OFFICE
539 Franklin Street
Buffalo, NY 14202-1109

T 716-884-9780
F 716-884-9787

DORMITORY AUTHORITY STATE OF NEW YORK

**WE FINANCE, BUILD AND
DELIVER.**

www.dasny.org



DASNY

ANDREW M. CUOMO
Governor

ALFONSO L. CARNEY, JR.
Chair

GERRARD P. BUSHELL, Ph.D.
President & CEO

SUPPLEMENTAL GENERAL REQUIREMENTS

PRE-BID SITE VISIT and REQUESTS FOR INFORMATION

PRE-BID CONFERENCE:

DATE: Monday, September 24, 2018 and Tuesday September 25, 2018 (alternate date)

TIME: 10:00 am

LOCATION: NYCCT - 285 Jay Street, Brooklyn, NY - Contact Ryan Murphy of Sciamè

ATTENDANCE AT THIS MEETING IS RECOMMENDED

For directions to the project site please contact DASNY's Construction Manager, Sciamè. Please contact Ryan Murphy at 917.295.8929.

Hardhats and proper footwear will be required to tour the site.

REQUESTS FOR INFORMATION:

DATE: All requests for information should be submitted to kcstell@dasny.org no later than **Wednesday, September 26, 2018**. The bid number must be referenced in the subject line. All responses will be posted to www.dasny.org as an Addendum to Bid No. 616 no later than **Thursday, October 4, 2018**. It is the responsibility of the bidder to obtain any and all Addenda issued.

CORPORATE HEADQUARTERS
515 Broadway
Albany, NY 12207-2964

T 518-257-3000
F 518-257-3100

NEW YORK CITY OFFICE
One Penn Plaza, 52nd Floor
New York, NY 10119-0098

T 212-273-5000
F 212-273-5121

BUFFALO OFFICE
539 Franklin Street
Buffalo, NY 14202-1109

T 716-884-9780
F 716-884-9787

DORMITORY AUTHORITY STATE OF NEW YORK

WE FINANCE, BUILD AND DELIVER.

www.dasny.org



DASNY

ANDREW M. CUOMO
Governor

ALFONSO L. CARNEY, JR.
Chair

GERRARD P. BUSHELL, Ph.D.
President & CEO

DETAILED SPECIFICATIONS and Scope of Work

CORPORATE HEADQUARTERS

515 Broadway
Albany, NY 12207-2964

T 518-257-3000
F 518-257-3100

NEW YORK CITY OFFICE

One Penn Plaza, 52nd Floor
New York, NY 10119-0098

T 212-273-5000
F 212-273-5121

BUFFALO OFFICE

539 Franklin Street
Buffalo, NY 14202-1109

T 716-884-9780
F 716-884-9787

DORMITORY AUTHORITY STATE OF NEW YORK

**WE FINANCE, BUILD AND
DELIVER.**

www.dasny.org

Lyon Workspace Products
PO Box 671
Aurora, Illinois 60507
Toll Free (800) 323-0082
Phone (630) 892-8941
Fax (800) 367-6681
Web Site www.lyonworkspace.com
E-Mail lyon@lyonworkspace.com

Product Guide Specification

SECTION 10501 (10 51 13)

STANDARD STEEL LOCKERS

2.1 MANUFACTURER

- A. Lyon Workspace Products, PO Box 671, Aurora, Illinois 60507. Toll Free (800) 323-0082. Phone (630) 892-8941. Fax (800) 367-6681. Web Site www.lyonworkspace.com. E-Mail lyon@lyonworkspace.com.

2.2 STEEL LOCKERS

- A. Model: Standard Quiet Lockers.
- B. Style: Single tier, Double tier and Triple tier as indicated on the drawings.
- C. Locker Size: As indicated on the Drawings
- D. Locker Configuration: As indicated on the Drawings
- E. Construction: Factory assembled
- F. Material:
 - 1. Steel: [ASTM A 1008, Class I, mild-annealed, cold-rolled steel, free from surface imperfections]
 - 2. Bolts: Zinc plated or other comparable rust-retardant treatment. Self-locking lock washers on moving parts
- G. Body:
 - 1. 24-gauge steel.
 - 2. Flanged to give double thickness of metal at back vertical corners.
- H. Door Frame:
 - 1. 16-gauge formed-steel channels.
 - 2. Vertical Members: Additional flange to form continuous door strike.
 - 3. Corners: Lapped and welded into rigid assembly.
 - 4. Bottom Cross Members: Tang at each end that fits through slot in rear flange of upright frame member to prevent twisting out of alignment.
 - 5. Top and Bottom Cross Members: Provide support for front edge of locker top and bottom.

I. Doors:

1. 1-piece, 16-gauge steel.
2. Single, Double, and Triple-Tier Locker Doors: Both vertical edges formed into channel-shaped formation. Top and bottom flanged at 90-degree angle.
3. Multiple-Tier Locker Doors: Hinge side formed into channel-shaped formation with other 3 sides flanged at 90-degree angle.
4. Multiple-Tier Locker Doors, Up to and Including 15 Inches Wide by 15 Inches High: 18-gauge steel, unless otherwise indicated.

REFER TO CONTACT
DOCUMENTS FOR
CONFIGURATION

J. Ventilation:

1. Perforated holes as shown on drawings

K. Hinges:

1. Height: Minimum of 2 inches.
2. Type: 0.050-inch thick steel, 5-knuckle, full-loop hinge forming double thickness on each leaf.
3. Attachment: Set hinges in slot in door and frame and projection welded to frame and securely attached to door.
4. Hinge Pin: Spun over at ends to resist removal.
5. Single-Tier Lockers, 48 Inches and Higher: 3 hinges.
6. All Other Tiers: 2 hinges.
7. Mounting: Right-hand side of door.

L. Multi-Point Locking Device:

1. Single-Tier Lockers, 48 Inches and Higher, Locking Device: Engage frame at 3 points.
2. Double and Triple-Tier Locking Device: Engage frame at 2 points.
3. Channel-Shaped Locking Device:
 - a. Full-length reinforcing ribs.
 - b. Quiet design using nylon-guide inserts to reduce metal-to-metal contact.
4. Lock Bar: Enclosed on 3 sides and operate within channel formation of door.
5. Locking Device: Prelocking so mechanism can be locked in open position. Door locking automatically when closed.
6. Door Jambs:
 - a. Single-Tier Lockers, 48 Inches and Higher: 3 door jambs.
 - b. Double and Triple-Tier Lockers: 2 jambs welded to side of door frames to engage locking device.
 - c. Safety Reverse Nose for Each Jamb: Eliminate hazard of sharp-pointed edges protruding into locker.
 - d. Easily replaceable soft rubber bumper for each jamb.
7. Doors: Provided with lock hole filler to permit use of built-in key or combination lock.

M. Handles:

1. Tamper-Guard Handles:
 - a. Single, double, and triple-tier lockers.
 - b. Chrome-plated, die-cast zinc alloy, with minimum tensile strength of 40,000 psi.
 - c. No moving parts shall operate against outside surface of locker.
 - d. Padlock Attachment: Integral part of lift, attached directly to locking bar and protected by fixed-handle housing.
 - e. Built-in padlock strike.

Reviewed by
F. J. Sciamè Construction
04/04/2017
105113-001.002-02

- N. Shelves:
1. Single-tier lockers.
 2. 1 shelf, approximately 9 inches below top.
 3. Single sheet, 24-gauge steel.
 4. Flanged on 4 sides.
 5. Safety Front Flange: Double flanged with second bend turned 45 degrees.
 6. Attachment: Minimum of 2 points through each side flange.

- O. Coat Hooks:
1. Single, double, and triple-tier lockers.
 2. 1 double-prong ceiling hook and 3 single-prong wall hooks.
 3. Steel rod stock with ball points for snag-free use.
 4. Attachment: 2 bolts.
 5. Finish: Zinc-plated or comparable rust-retardant treatment.

2.3 ACCESSORIES

PROVIDE SAMPLE FOR REVIEW AND NUMBERING CONVENTION PARAMETERS FOR REVIEW.

- A. Number Plates:
1. Aluminum.
 2. Size: 2-3/4 inches wide by 1 inch high.
 3. Numbers: Clearly etched numbers a minimum of 3/8 inch high.
 4. Attachment: Attach in prepunched holes near top of doors.

- B. Tops: 20 gauge Continuous-~~sloping hoods~~

DELETE SLOPING HOOD OPTION

- C. Bases: Z-type, 14-gauge steel, 4 inches high

- D. Floor Anchoring: Anchor lockers to floor in accordance with manufacturer's instructions.

- E. Closures and Fillers:

1. Top closures, closure strips, front expansion fillers, and corner fillers.
2. Fill spaces between 2 lockers or between lockers and walls as required for proper fit.

- F. End Panels:

1. End Finishing Panels: 16-gauge steel, no bolt heads exposed.

2.5 FINISH

NO EXPOSED FASTENERS

- A. General: Factory apply finish in accordance with manufacturer's instructions.

- B. Standard Finish: Exposed steel parts shall be thoroughly cleaned, given bonding and rust-inhibitive phosphate treatment, and electrostatically sprayed with powder coat. Baked-on finish.

PART 3 EXECUTION

COMPLY WITH LEED CRITERIA AS PER SPEC

3.1 EXAMINATION

- A. Examine areas to receive lockers. Notify Architect if areas are not acceptable. Do not begin installation until unacceptable conditions have been corrected.

Reviewed by
F. J. Sciame Construction
04/04/2017
105113-001.002-02

DELETE SLOPING HOOD OPTION

3.2 INSTALLATION

- A. Install lockers in accordance with manufacturer's instructions at locations indicated on the Drawings.
- B. Install lockers plumb, level, square, rigid, with flush installation.
- C. Use manufacturer's supplied hardware.
- D. Anchoring: Anchor lockers to floors and walls as indicated on the Drawings.
- E. ~~Sloping Hoods and Metal Fillers: Install sloping hoods and metal fillers using concealed fasteners.~~
- F. Joints: Provide flush hairline joints against adjacent surfaces.
- G. Number Plates: Attach number plates to face of doors level with 2 aluminum rivets. Attach in sequence as indicated on the Drawings.
- H. Locker Benches: Install locker benches by fastening bench tops to pedestals and securely anchoring to floor using appropriate anchors.
- I. Repair minor damages to finish in accordance with manufacturer's instructions and as approved by Architect.
- J. Remove and replace defective or damaged components that cannot be successfully repaired as determined by Architect.

3.3 ADJUSTING

- A. Adjust doors, locks, and operating hardware to function properly and for smooth operation without binding.

3.4 CLEANING

- A. Clean surfaces promptly after installation in accordance with manufacturer's instructions.
- B. Do not use harsh cleaning materials or methods that could damage finish.

3.5 PROTECTION

- A. Protect installed lockers from damage during construction.

END OF SECTION

PROVIDE SAMPLE FOR REVIEW AND NUMBERING CONVENTION PARAMETERS FOR REVIEW.

Reviewed by
F. J. Sciamè Construction
04/04/2017
105113-001.002-02

1. Lyon is an approved manufacturer and they are following the specification and return submittal dated 2/22/17
2. The ventilation type is custom for the lockers, at this time there are no photos available
3. CRG is the specified Club Resource Group company
4. CRG does not provide product data, they only provide attached drawing (page 18)
5. Locker color samples were previously submitted
6. Bench hard color sample to be submitted in the future
7. Lyon LEED data submitted and approved previously, CRG LEED data to be submitted in a separate submittal
8. Door swing is right hinge, this is an industry standard and cannot be changed
9. Bench size of 9' and 3'6" does not exist from the CRG, 8' and 4' benches are provided

1. PRODUCT DATA MUST CLEARLY SHOW PHOTOS OF ACTUAL PRODUCT.
2. REFER TO COMMENTS ATTACHED.
3. COORDINATE SIZES AND LOCATIONS WITH CONTRACT DOCUMENTS.
4. DELETE SLOPING HOOD OPTION AND PROVIDE CREDIT FOR MATERIAL AND LABOR.
5. PROVIDE REQ'D LEED CRITERIA AS PER SPECS.
6. NO EXPOSED FASTENERS.



DASNY

ANDREW M. CUOMO
Governor

ALFONSO L. CARNEY, JR.
Chair

GERRARD P. BUSHELL, Ph.D.
President & CEO

DRAWINGS

CORPORATE HEADQUARTERS

515 Broadway
Albany, NY 12207-2964

T 518-257-3000
F 518-257-3100

NEW YORK CITY OFFICE

One Penn Plaza, 52nd Floor
New York, NY 10119-0098

T 212-273-5000
F 212-273-5121

BUFFALO OFFICE

539 Franklin Street
Buffalo, NY 14202-1109


T 716-884-9780
F 716-884-9787

DORMITORY AUTHORITY STATE OF NEW YORK


**WE FINANCE, BUILD AND
DELIVER.**

www.dasny.org


DELETE SLOPED HOOD OPTION; TYPICAL

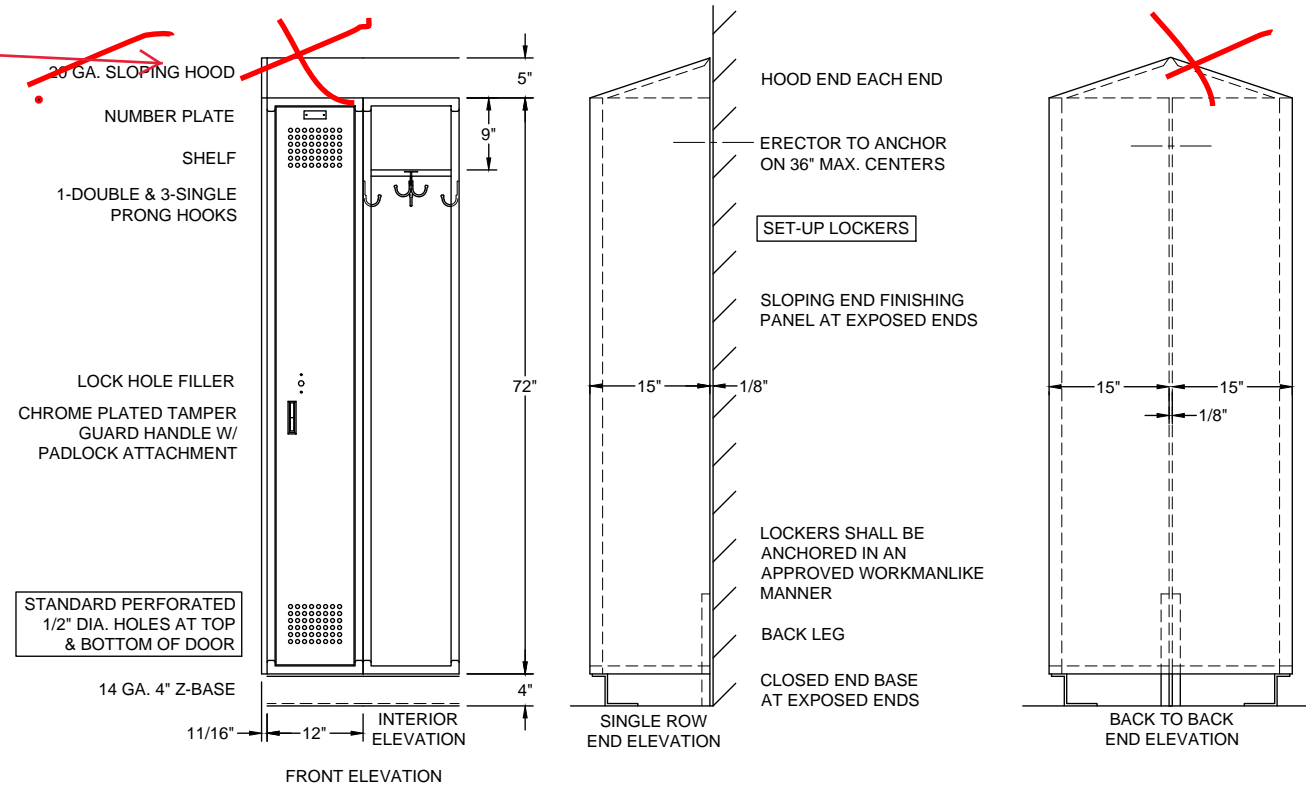

LOCKER ROOMS (LL206, LL209, LL210, LL211)
(LOC-01) 81 SET-UP LOCKER FRAMES 12" X 15" X 72" S.R.S.T. W/ ~~SLOPING HOOD~~ & 4" Z-BASE

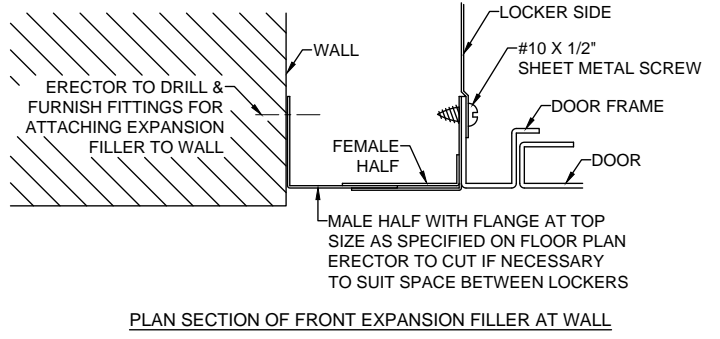


PLAN SECTION OF FRONT EXPANSION FILLER AT WALL

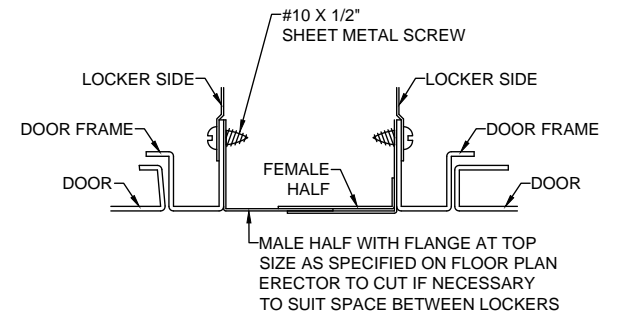


TYPICAL DETAIL OF FRONT EXPANSION FILLER

DELETE SLOPED HOOD OPTION; TYPICAL
SUBMIT SAMPLE OF NUMBER PLATE

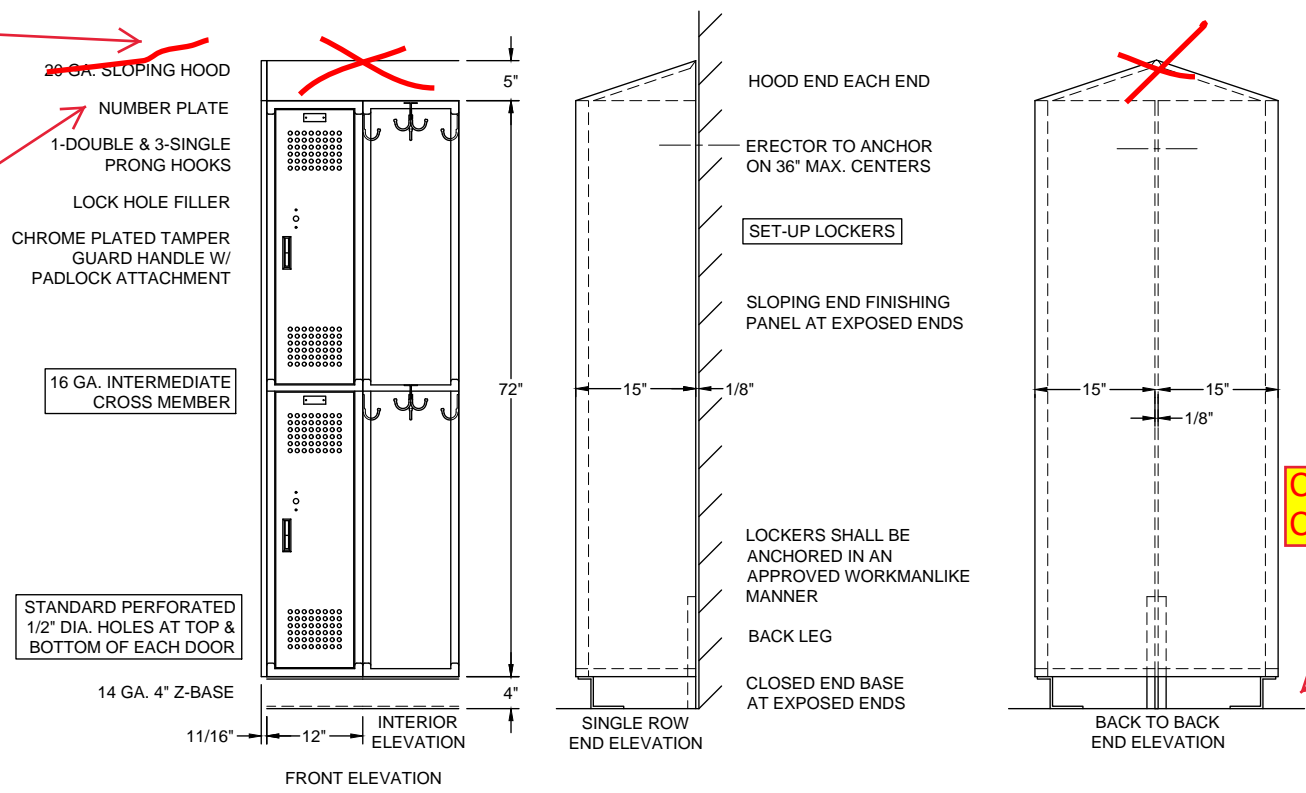

LOCKER ROOMS (LL206, LL209, LL210, LL211), GOWN ROOMS (707, 707.01)
CORRIDORS (400.07, 400.09, 500.08, 600.01, 600.02, 600.03, 800.08)
(LOC-02) 542 SET-UP LOCKER FRAMES 12" X 15" X 36" S.R.D.T. W/ ~~SLOPING HOOD~~ & 4" Z-BASE


CLARIFY BASE COLOR.

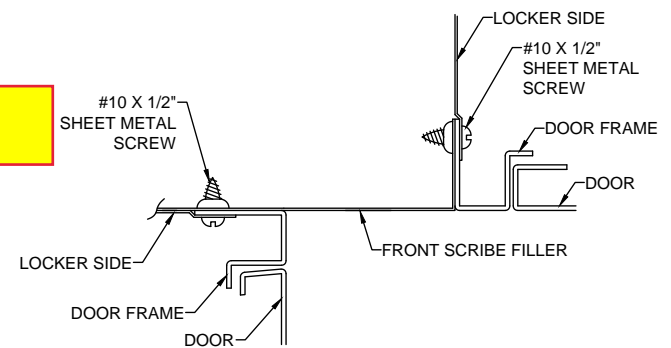

PLAN SECTION OF FRONT SCRIBE FILLER


Reviewed by
F. J. Sciamè Construction
04/04/2017
105113-001.001-02

ARCHITECT APPROVAL		
APPROVED AS NOTED	INITIAL	DATE
REVISION AS NOTED		
RE-SUBMIT		
NUMBER SEQUENCE ATTACHED		
COLOR PLAN ATTACHED		
FINAL APPROVAL	INITIAL	DATE
CHECKED BY	INITIAL	DATE
<small>NOTICE: THIS DOCUMENT IS CONFIDENTIAL AND PROPRIETARY. NO PART OF THIS DOCUMENT MAY BE DISCLOSED IN ANY MANNER TO A THIRD PARTY WITHOUT THE PRIOR WRITTEN CONSENT OF LYON L.L.C.</small>		
PROJECT: CUNY CITY TECH ACADEMIC BUILDING		
LOCATION: BROOKLYN, NY		
ARCHITECT:		
CONTRACTOR: NU-TECH FURNISHINGS INC ISLANDIA, NY		
DRAWN BY: JZ	DATE: JULY 19, 2016	
<small>www.lyonworkspace.com</small>		
REVISED DATES	PRE-CHECK DATES	
3/7 2017	3/22 2017	
REVISED BY: JZ	CHECKED BY: -	
DWG NO: 16253	ORDER NO: 710165	

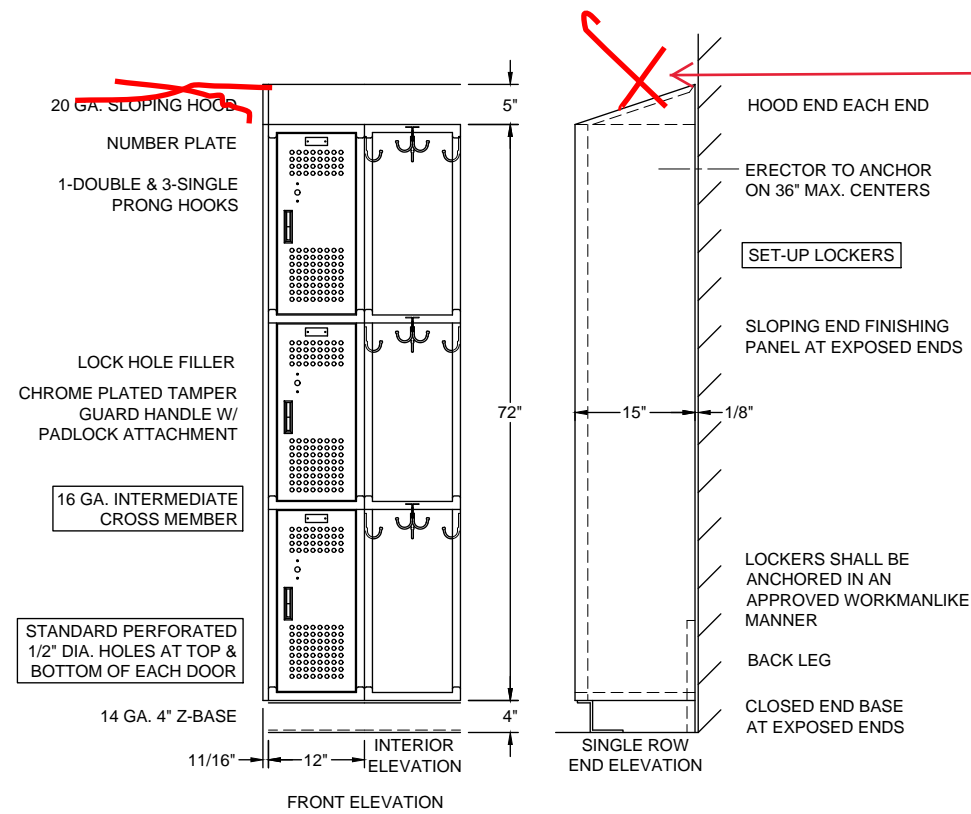

CORRIDORS (600.07, 600.09)
 (LOC-03) 40 SET-UP LOCKER FRAMES 12" X 15" X 24" S.R.3.T. W/ SLOPING HOOD & 4" Z-BASE


DELETE SLOPED HOOD OPTION; TYPICAL

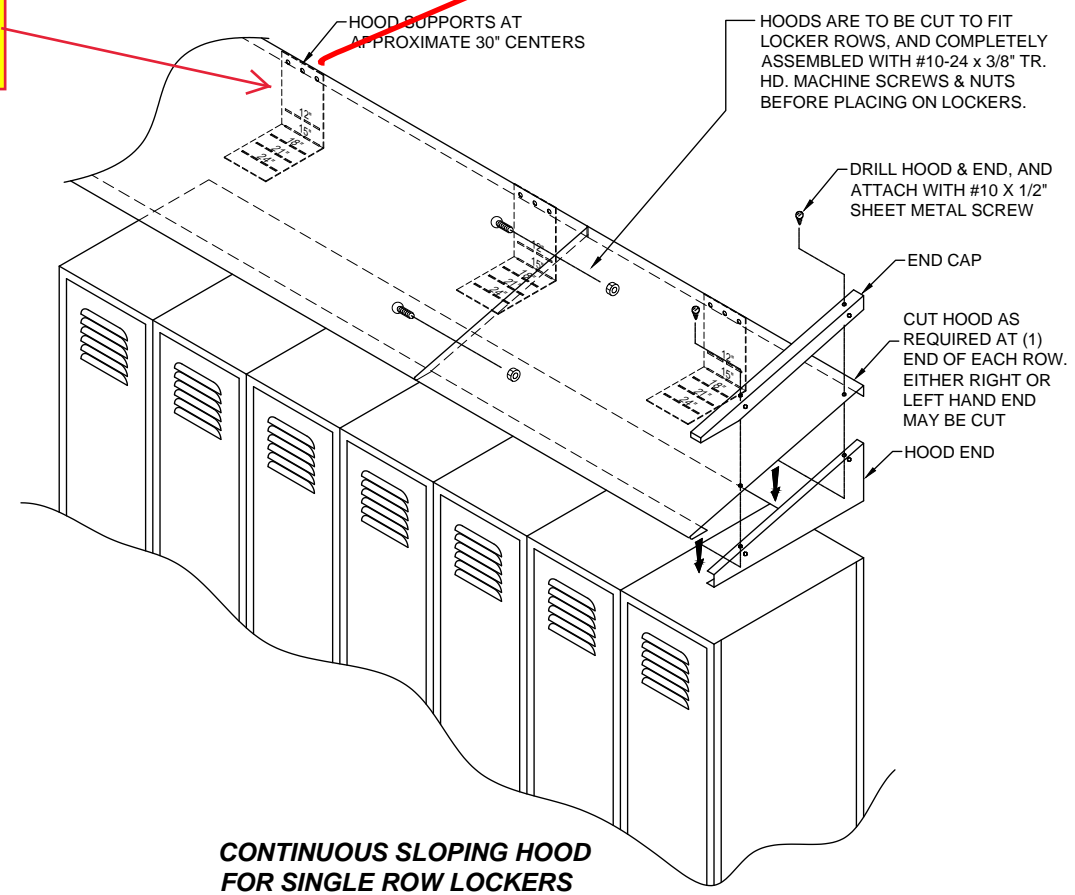


CONTINUOUS SLOPING HOOD FOR SINGLE ROW LOCKERS

**- CONFIRM 2 POINT LATCHING.
 - VANDAL PROOF LIFT HANDLE
 - BAKED ENAMEL FINISH
 - NUMBER PLATES ATTACHED WITH SAME FINISH FASTENERS.**

DELETE SLOPED HOOD OPTION; TYPICAL

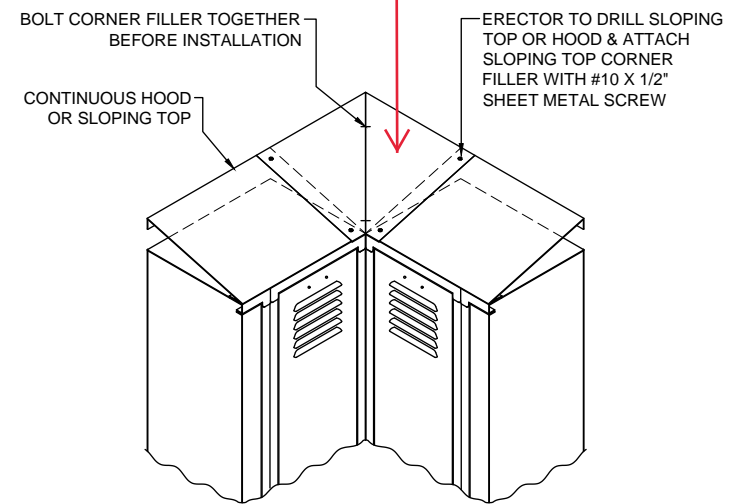

INSTALLATION OF SLOPING TOP CORNER FILLER

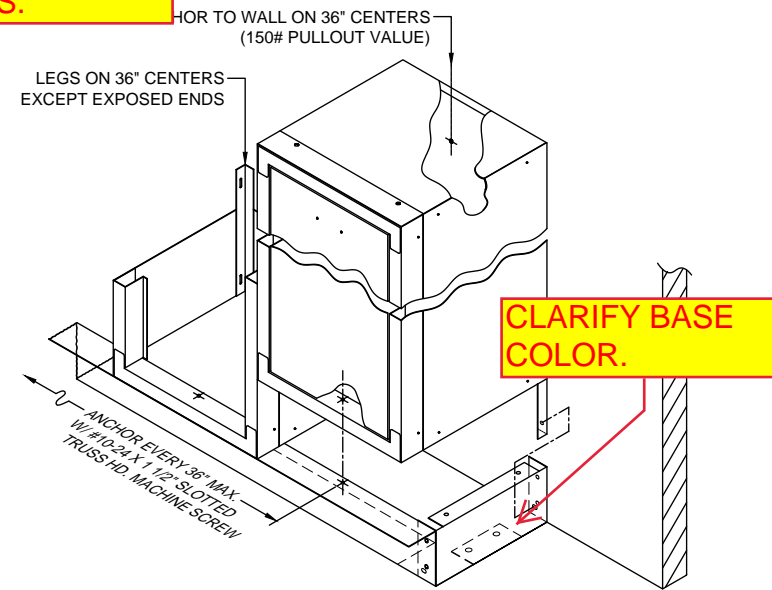

CLARIFY BASE COLOR.

"Z" BASE W/ CLOSED ENDS ASSEMBLY FOR SINGLE ROW LOCKERS

Reviewed by
F. J. Sciamè Construction
 04/04/2017
 105113-001.001-02

ARCHITECT APPROVAL		
APPROVED AS NOTED	INITIAL	DATE
REVISION AS NOTED		
RE-SUBMIT		
NUMBER SEQUENCE ATTACHED		
COLOR PLAN ATTACHED		
FINAL APPROVAL	INITIAL	DATE
CHECKED BY	INITIAL	DATE
<small>NOTICE: THIS DOCUMENT IS CONFIDENTIAL AND PROPRIETARY. NO PART OF THIS DOCUMENT MAY BE DISCLOSED IN ANY MANNER TO A THIRD PARTY WITHOUT THE PRIOR WRITTEN CONSENT OF LYON L.L.C.</small>		
PROJECT: CUNY CITY TECH ACADEMIC BUILDING		
LOCATION: BROOKLYN, NY		
ARCHITECT:		
CONTRACTOR: NU-TECH FURNISHINGS INC ISLANDIA, NY		
DRAWN BY: JZ	DATE: JULY 19, 2016	
<small>www.lyonworkspace.com</small>		
REVISED DATES	PRE-CHECK DATES	
3/7 2017	3/22 2017	
REVISED BY: JZ	CHECKED BY: -	
DWG NO: 16253	ORDER NO: 710165	

THIS PAGE INTENTIONALLY LEFT BLANK

ALL BENCHES HAVE BEEN REMOVED

Benches on pages __ - __, type by different supplier due to waterfall type

Reviewed by
F. J. Sciamè Construction
04/04/2017
105113-001.001-02

ARCHITECT APPROVAL

APPROVED AS NOTED	INITIAL	DATE
REVISION AS NOTED		
RE-SUBMIT		
NUMBER SEQUENCE ATTACHED		
COLOR PLAN ATTACHED		
FINAL APPROVAL	INITIAL	DATE
CHECKED BY	INITIAL	DATE

NOTICE: THIS DOCUMENT IS CONFIDENTIAL AND PROPRIETARY. NO PART OF THIS DOCUMENT MAY BE DISCLOSED IN ANY MANNER TO A THIRD PARTY WITHOUT THE PRIOR WRITTEN CONSENT OF LYON L.L.C.

PROJECT:
**CUNY CITY TECH
ACADEMIC BUILDING**

LOCATION:
BROOKLYN, NY

ARCHITECT:

CONTRACTOR:
NU-TECH FURNISHINGS INC
ISLANDIA, NY

DRAWN BY: **JZ** DATE: **JULY 19, 2016**


LYON LYON, L.L.C.
P.O. BOX 671
AURORA, IL 60507-0671
P: 800-323-0082
www.lyonworkspace.com

REVISED DATES	PRE-CHECK DATES
9/8 2016	3/7 2017

REVISED BY: **JZ** CHECKED BY: -

DWG NO: 16253 ORDER NO: 710165

Door swing is right hinge, this is an industry standard and cannot be changed

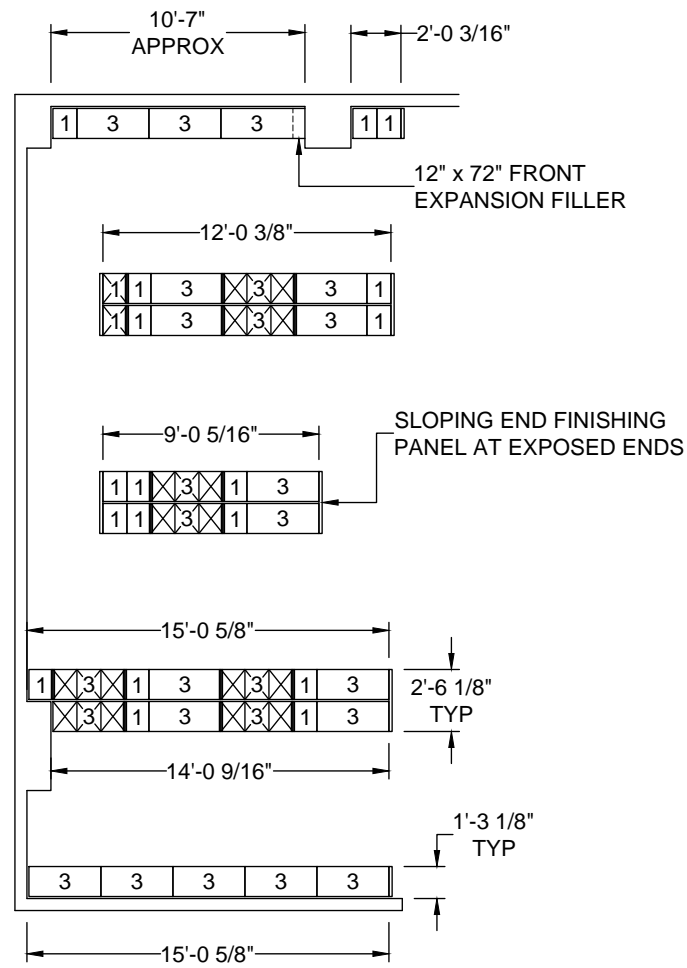


women's 01/A-530

WOMENS LOCKER ROOM (LL210)

- (LOC-01) 26 SET-UP LOCKER FRAMES 12" X 15" X 72" S.R.S.T. W/ SLOPING HOOD & 4" Z-BASE
- (LOC-02) 72 SET-UP LOCKER FRAMES 12" X 15" X 36" S.R.D.T. W/ SLOPING HOOD & 4" Z-BASE

COLOR LOCKER PARTS: _____

NUMBERING SEQUENCE: _____

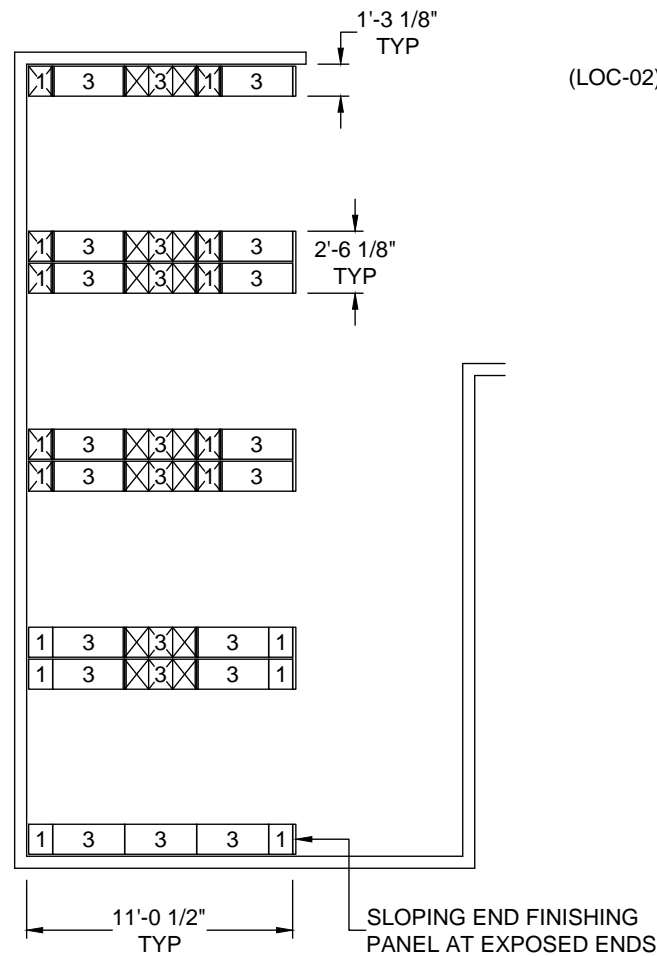


men's 01/A-530

MENS LOCKER ROOM (LL206)

- (LOC-01) 31 SET-UP LOCKER FRAMES 12" X 15" X 72" S.R.S.T. W/ SLOPING HOOD & 4" Z-BASE
- (LOC-02) 57 SET-UP LOCKER FRAMES 12" X 15" X 36" S.R.D.T. W/ SLOPING HOOD & 4" Z-BASE

COLOR LOCKER PARTS: _____

NUMBERING SEQUENCE: _____

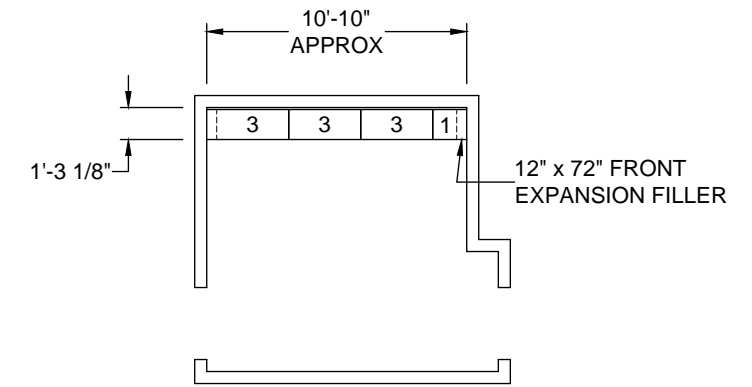

1/A-530

REFEREE LOCKERS (LL208)

(LOC-02) 10 SET-UP LOCKER FRAMES 12" X 15" X 36" S.R.D.T. W/ SLOPING HOOD & 4" Z-BASE

COLOR LOCKER PARTS: _____

NUMBERING SEQUENCE: _____


PROVIDE PARAMETERS FOR THE NUMBERING.

- # OF CHARACTERS
- FONT
- MATERIAL
- SUBMIT SAMPLE FOR REVIEW.

Reviewed by
F. J. Sciamè Construction
 04/04/2017
 105113-001.001-02

ARCHITECT APPROVAL		
APPROVED AS NOTED	INITIAL	DATE
REVISION AS NOTED		
RE-SUBMIT		
NUMBER SEQUENCE ATTACHED		
COLOR PLAN ATTACHED		
FINAL APPROVAL	INITIAL	DATE
CHECKED BY	INITIAL	DATE
<small>NOTICE: THIS DOCUMENT IS CONFIDENTIAL AND PROPRIETARY. NO PART OF THIS DOCUMENT MAY BE DISCLOSED IN ANY MANNER TO A THIRD PARTY WITHOUT THE PRIOR WRITTEN CONSENT OF LYON L.L.C.</small>		
PROJECT:		
CUNY CITY TECH ACADEMIC BUILDING		
LOCATION: BROOKLYN, NY		
ARCHITECT:		
CONTRACTOR:		
NU-TECH FURNISHINGS INC ISLANDIA, NY		
DRAWN BY: JZ	DATE: JULY 19, 2016	
<small>LYON, L.L.C. P.O. BOX 671 AURORA, IL 60507-0671 P: 800-323-0082</small>		
REVISED DATES	PRE-CHECK DATES	
9/8 2016	3/7 2017	
REVISED BY: JZ	CHECKED BY: -	
DWG NO: 16253	ORDER NO: 710165	

Door swing is right hinge, this is an industry standard and cannot be changed

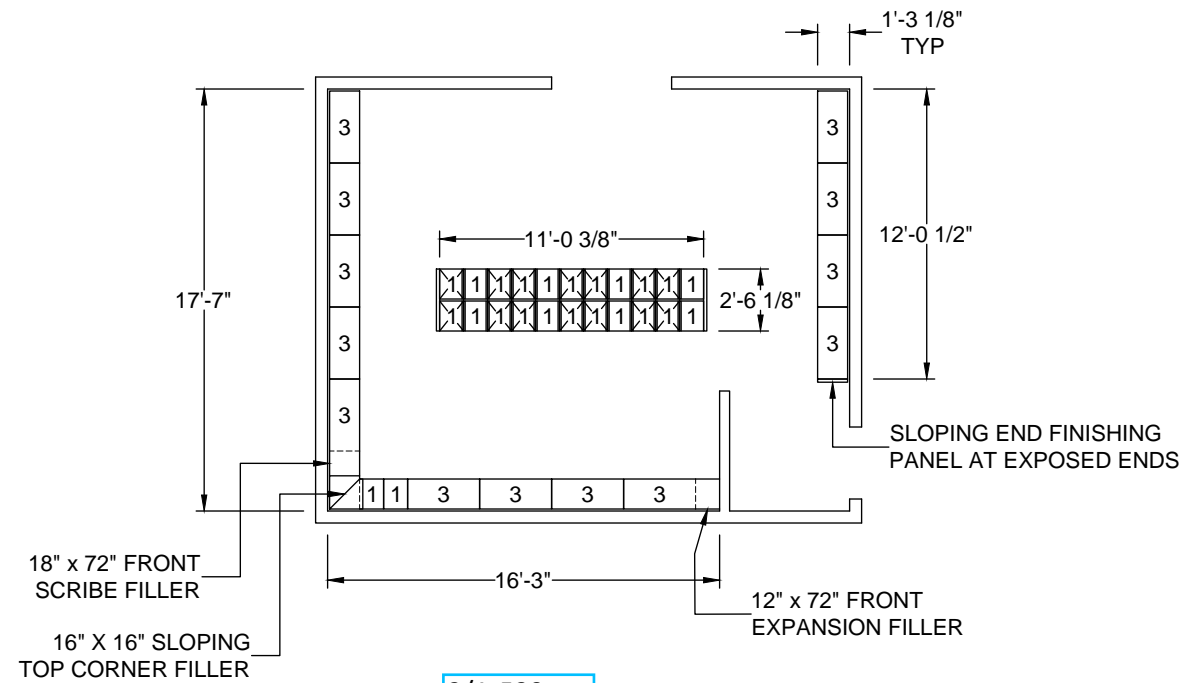


2/A-530

TEAM LOCKER ROOM (LL209)

- (LOC-01) 14 SET-UP LOCKER FRAMES 12" X 15" X 72" S.R.S.T. W/ ~~SLOPING HOOD~~ & 4" Z-BASE
- (LOC-02) 49 SET-UP LOCKER FRAMES 12" X 15" X 36" S.R.D.T. W/ ~~SLOPING HOOD~~ & 4" Z-BASE

COLOR LOCKER PARTS: _____
 NUMBERING SEQUENCE: _____

PROVIDE PARAMETERS FOR THE NUMBERING.
 -# OF CHARACTERS
 - FONT
 - MATERIAL
 -SUMBIT SAMPLE FOR REVIEW.

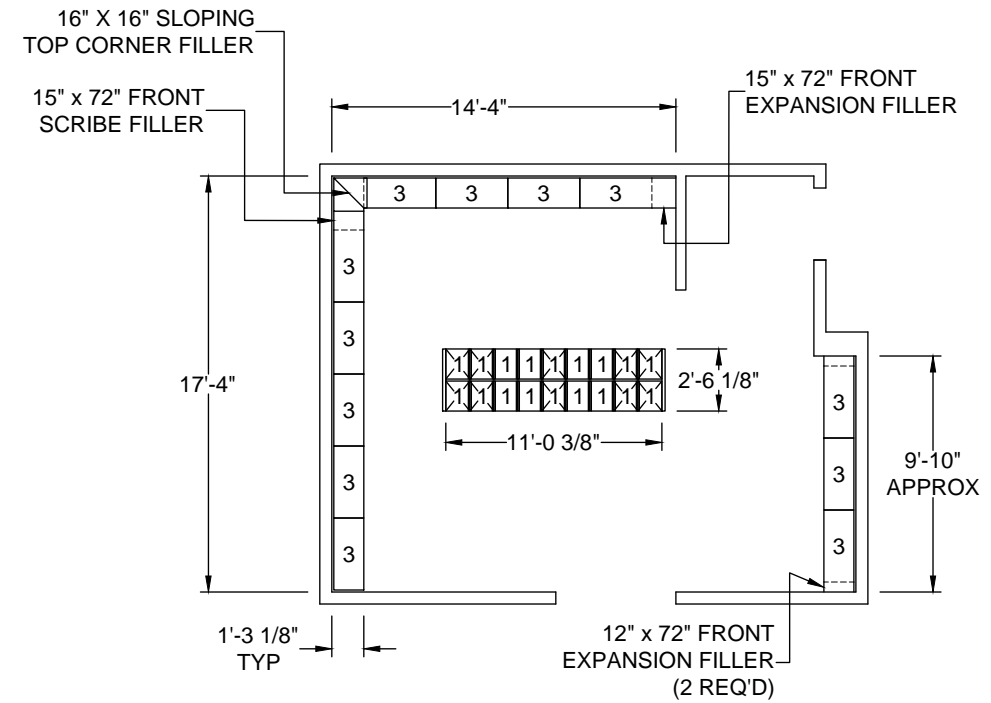

2/A-530


TEAM LOCKER ROOM (LL211)

- (LOC-01) 10 SET-UP LOCKER FRAMES 12" X 15" X 72" S.R.S.T. W/ ~~SLOPING HOOD~~ & 4" Z-BASE
- (LOC-02) 44 SET-UP LOCKER FRAMES 12" X 15" X 36" S.R.D.T. W/ ~~SLOPING HOOD~~ & 4" Z-BASE

COLOR LOCKER PARTS: _____
 NUMBERING SEQUENCE: _____

Reviewed by
F. J. Sciamè Construction
 04/04/2017
 105113-001.001-02

ARCHITECT APPROVAL		
APPROVED AS NOTED	INITIAL	DATE
REVISION AS NOTED		
RE-SUBMIT		
NUMBER SEQUENCE ATTACHED		
COLOR PLAN ATTACHED		
FINAL APPROVAL	INITIAL	DATE
CHECKED BY	INITIAL	DATE
<small>NOTICE: THIS DOCUMENT IS CONFIDENTIAL AND PROPRIETARY. NO PART OF THIS DOCUMENT MAY BE DISCLOSED IN ANY MANNER TO A THIRD PARTY WITHOUT THE PRIOR WRITTEN CONSENT OF LYON L.L.C.</small>		
PROJECT: CUNY CITY TECH ACADEMIC BUILDING		
LOCATION: BROOKLYN, NY		
ARCHITECT:		
CONTRACTOR: NU-TECH FURNISHINGS INC ISLANDIA, NY		
DRAWN BY: JZ	DATE: JULY 19, 2016	
LYON, L.L.C. P.O. BOX 671 AURORA, IL 60507-0671 P: 800-323-0082		
REVISED DATES	PRE-CHECK DATES	
9/8 2016	3/7 2017	
REVISED BY: JZ	CHECKED BY: -	
DWG NO: 16253	ORDER NO: 710165	

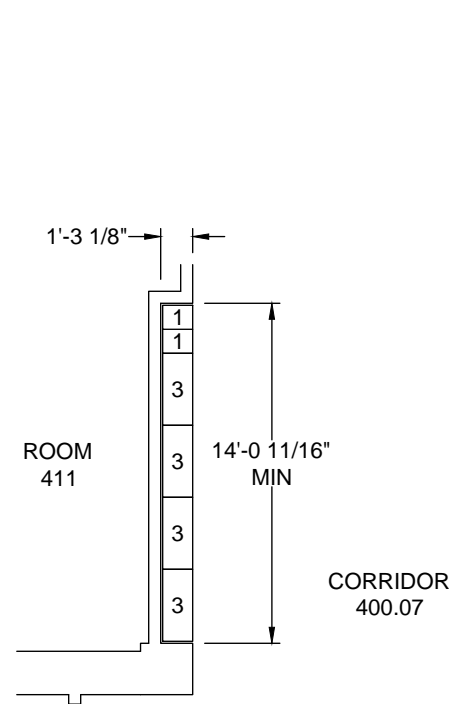


1/A-544

CORRIDOR LOCKERS (400.07)

(LOC-02) 14 SET-UP LOCKER FRAMES 12" X 15" X 36" S.R.D.T. W/ SLOPING HOOD & 4" Z-BASE

COLOR LOCKER PARTS: _____
 NUMBERING SEQUENCE: _____

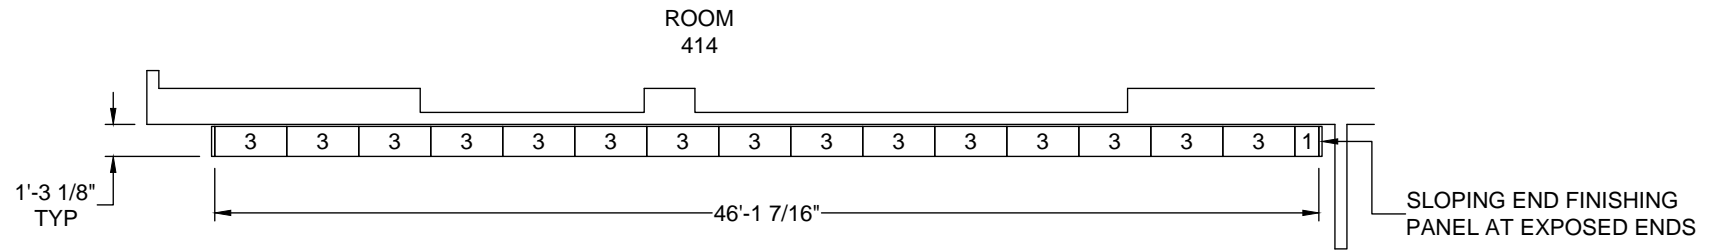


6/A-547

CORRIDOR LOCKERS (400.09)

(LOC-02) 46 SET-UP LOCKER FRAMES 12" X 15" X 36" S.R.D.T. W/ SLOPING HOOD & 4" Z-BASE

COLOR LOCKER PARTS: _____
 NUMBERING SEQUENCE: _____

PROVIDE PARAMETERS FOR THE NUMBERING.
 -# OF CHARACTERS
 - FONT
 - MATERIAL
 -SUMBIT SAMPLE FOR REVIEW.

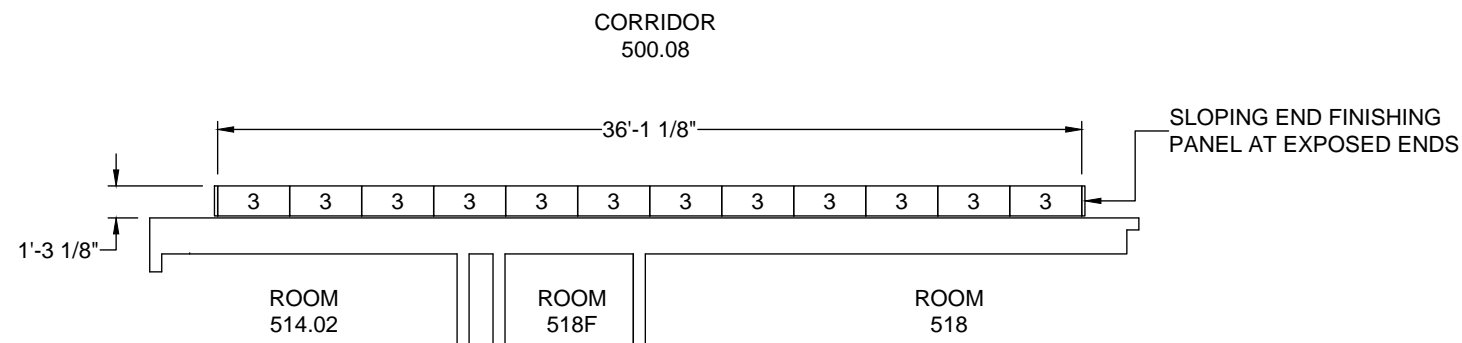

2/A-547

CORRIDOR LOCKERS (500.08)

(LOC-02) 36 SET-UP LOCKER FRAMES 12" X 15" X 36" S.R.D.T. W/ SLOPING HOOD & 4" Z-BASE

COLOR LOCKER PARTS: _____
 NUMBERING SEQUENCE: _____


Reviewed by
F. J. Sciamè Construction
 04/04/2017
 105113-001.001-02

ARCHITECT APPROVAL

APPROVED AS NOTED	INITIAL	DATE
REVISION AS NOTED		
RE-SUBMIT		
NUMBER SEQUENCE ATTACHED		
COLOR PLAN ATTACHED		
FINAL APPROVAL	INITIAL	DATE
CHECKED BY	INITIAL	DATE

NOTICE: THIS DOCUMENT IS CONFIDENTIAL AND PROPRIETARY. NO PART OF THIS DOCUMENT MAY BE DISCLOSED IN ANY MANNER TO A THIRD PARTY WITHOUT THE PRIOR WRITTEN CONSENT OF LYON L.L.C.

PROJECT:	
CUNY CITY TECH ACADEMIC BUILDING	
LOCATION: BROOKLYN, NY	
ARCHITECT:	
CONTRACTOR: NU-TECH FURNISHINGS INC ISLANDIA, NY	
DRAWN BY: JZ	DATE: JULY 19, 2016
<small>LYON, L.L.C. P.O. BOX 671 AURORA, IL 60507-0671 P: 800-323-0082</small>	
REVISED DATES	PRE-CHECK DATES
3/7 2017	
REVISED BY: JZ	CHECKED BY: -
DWG NO: 16253	ORDER NO: 710165

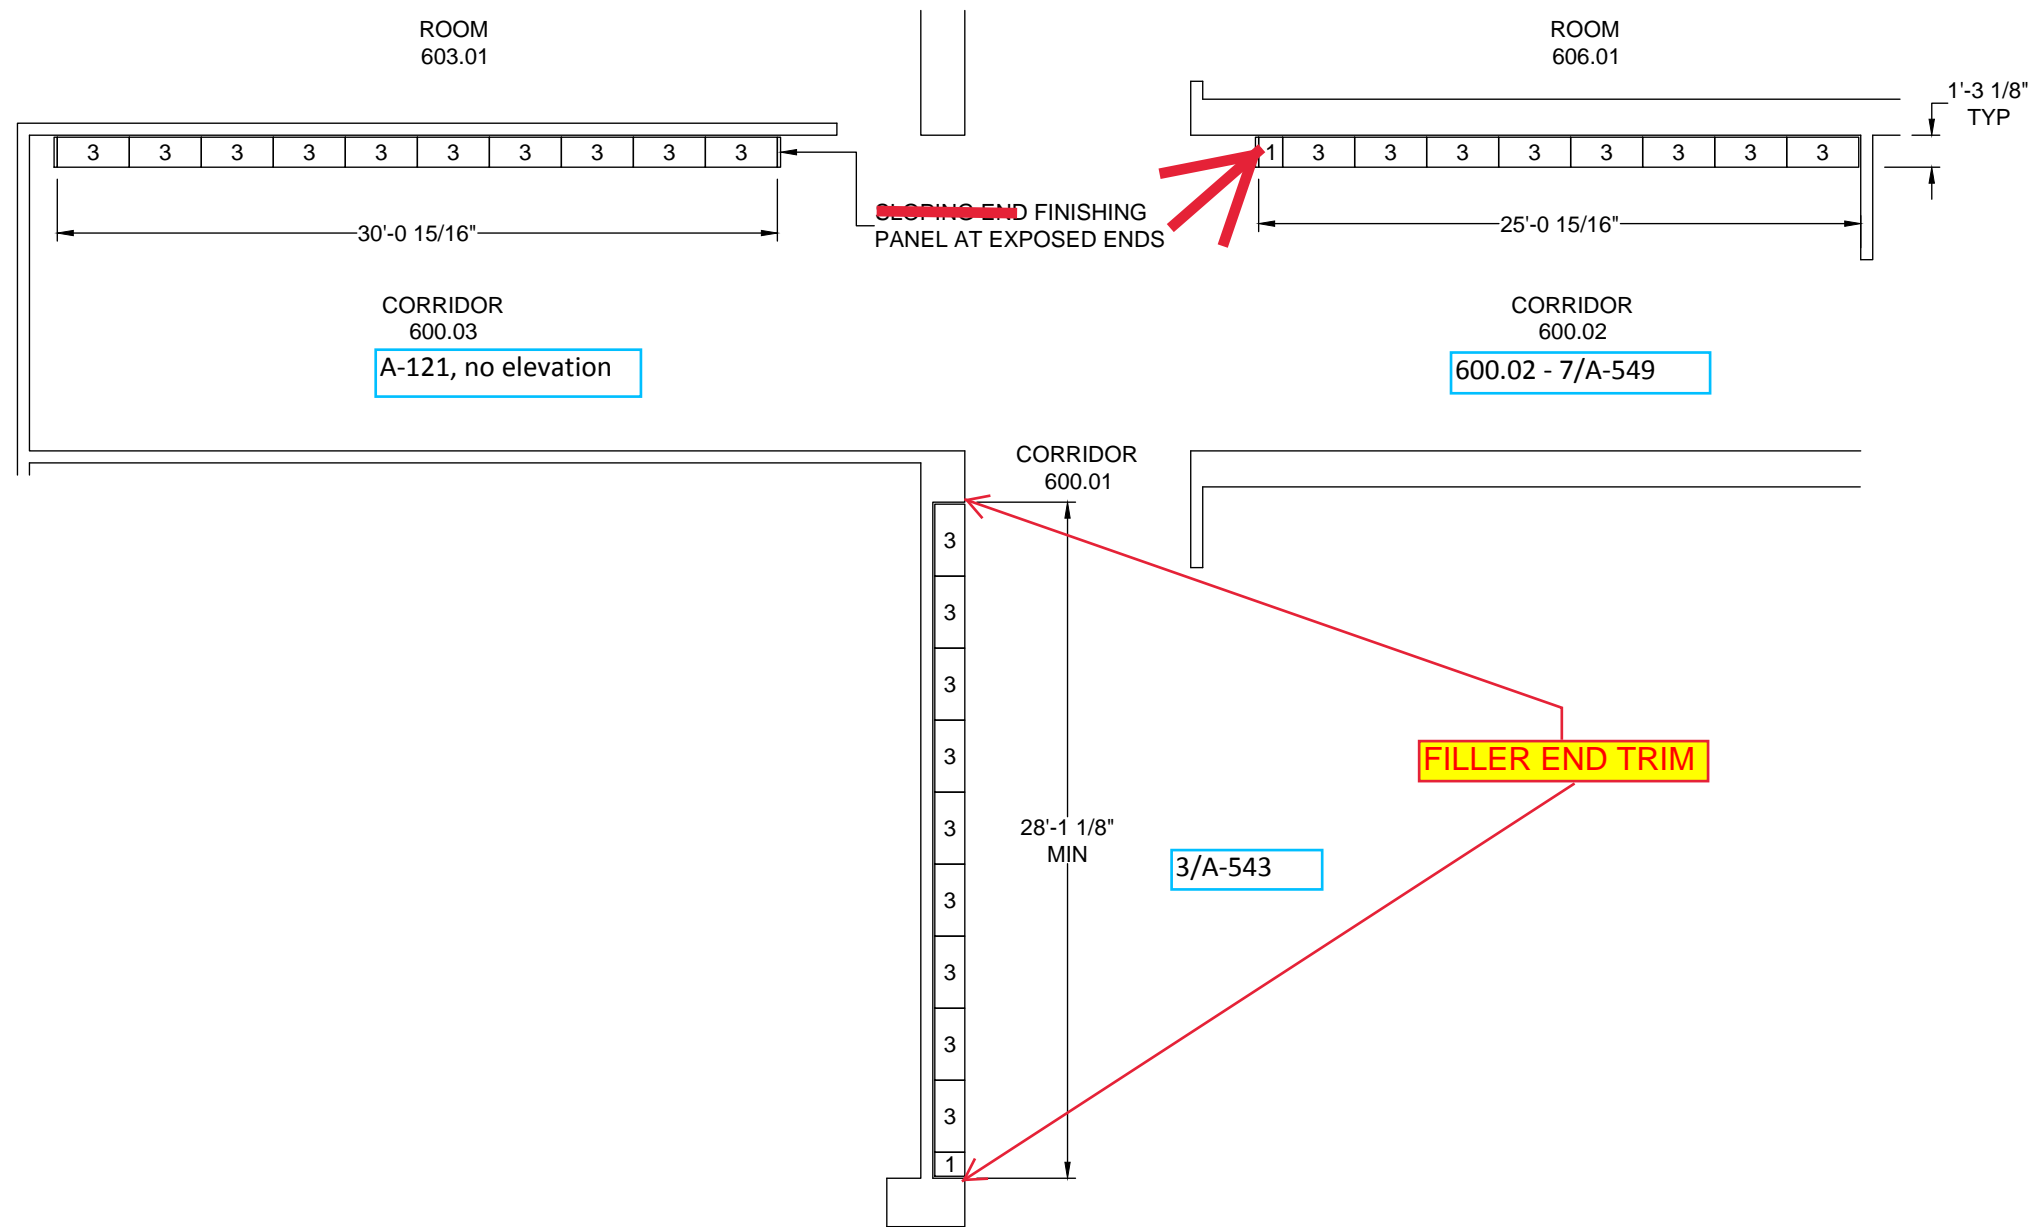

CORRIDOR LOCKERS (600.01, 600.02, 600.03)
 (LOC-02) 83 SET-UP LOCKER FRAMES 12" X 15" X 36" S.R.D.T. W/ ~~SLOPING HOOD~~ & 4" Z-BASE

COLOR LOCKER PARTS: _____
 NUMBERING SEQUENCE: _____

PROVIDE PARAMETERS FOR THE NUMBERING.
 -# OF CHARACTERS
 - FONT
 - MATERIAL
 -SUMBIT SAMPLE FOR REVIEW.

Reviewed by
F. J. Sciamè Construction
 04/04/2017
 105113-001.001-02

ARCHITECT APPROVAL

APPROVED AS NOTED	INITIAL	DATE
REVISION AS NOTED		
RE-SUBMIT		
NUMBER SEQUENCE ATTACHED		
COLOR PLAN ATTACHED		
FINAL APPROVAL	INITIAL	DATE
CHECKED BY	INITIAL	DATE


NOTICE: THIS DOCUMENT IS CONFIDENTIAL AND PROPRIETARY. NO PART OF THIS DOCUMENT MAY BE DISCLOSED IN ANY MANNER TO A THIRD PARTY WITHOUT THE PRIOR WRITTEN CONSENT OF LYON L.L.C.

PROJECT:
CUNY CITY TECH ACADEMIC BUILDING
 LOCATION: BROOKLYN, NY
 ARCHITECT:

CONTRACTOR:
 NU-TECH FURNISHINGS INC
 ISLANDIA, NY

DRAWN BY: **JZ** DATE: **JULY 19, 2016**
 LYON, L.L.C.
 P.O. BOX 671
 AURORA, IL 60507-0671
 P: 800-323-0082

REVISED DATES	PRE-CHECK DATES
3/7 2017	
REVISED BY: JZ	CHECKED BY: -
DWG NO: 16253	ORDER NO: 710165

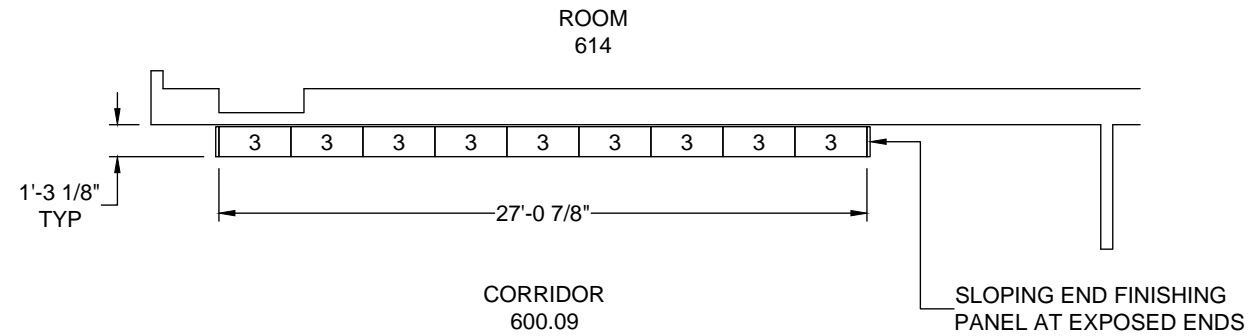


8/A-547

CORRIDOR LOCKERS (600.09)

(LOC-03) 27 SET-UP LOCKER FRAMES 12" X 15" X 24" S.R.3.T. W/ ~~SLOPING HOOD~~ & 4" Z-BASE

COLOR LOCKER PARTS: _____

NUMBERING SEQUENCE: _____

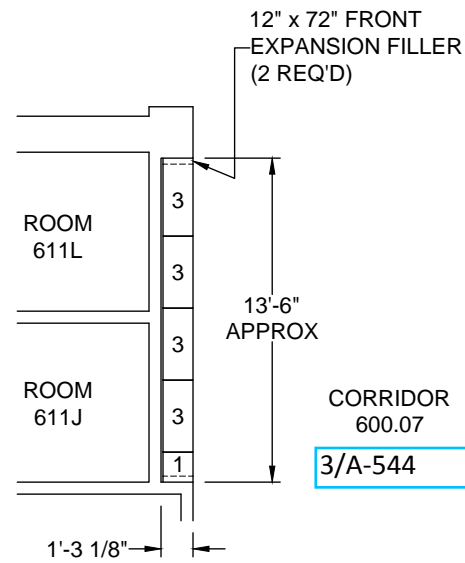

3/A-544

CORRIDOR LOCKERS (600.07)

(LOC-03) 13 SET-UP LOCKER FRAMES 12" X 15" X 24" S.R.3.T. W/ ~~SLOPING HOOD~~ & 4" Z-BASE

COLOR LOCKER PARTS: _____

NUMBERING SEQUENCE: _____

PROVIDE PARAMETERS FOR THE NUMBERING.
 -# OF CHARACTERS
 - FONT
 - MATERIAL
 -SUMBIT SAMPLE FOR REVIEW.

Reviewed by
F. J. Sciamè Construction
 04/04/2017
 105113-001.001-02

ARCHITECT APPROVAL

APPROVED AS NOTED	INITIAL	DATE
REVISION AS NOTED		
RE-SUBMIT		
NUMBER SEQUENCE ATTACHED		
COLOR PLAN ATTACHED		
FINAL APPROVAL	INITIAL	DATE
CHECKED BY	INITIAL	DATE


NOTICE: THIS DOCUMENT IS CONFIDENTIAL AND PROPRIETARY. NO PART OF THIS DOCUMENT MAY BE DISCLOSED IN ANY MANNER TO A THIRD PARTY WITHOUT THE PRIOR WRITTEN CONSENT OF LYON L.L.C.

PROJECT:
**CUNY CITY TECH
 ACADEMIC BUILDING**
 LOCATION: BROOKLYN, NY
 ARCHITECT:

CONTRACTOR:
 NU-TECH FURNISHINGS INC
 ISLANDIA, NY

DRAWN BY: **JZ** DATE: **JULY 19, 2016**
 LYON, L.L.C.
 P.O. BOX 671
 AURORA, IL 60507-0671
 P: 800-323-0082
 www.lyonworkspace.com

REVISED DATES	PRE-CHECK DATES
3/7 2017	
REVISOR BY: JZ	CHECKED BY: -
DWG NO: 16253	ORDER NO: 710165

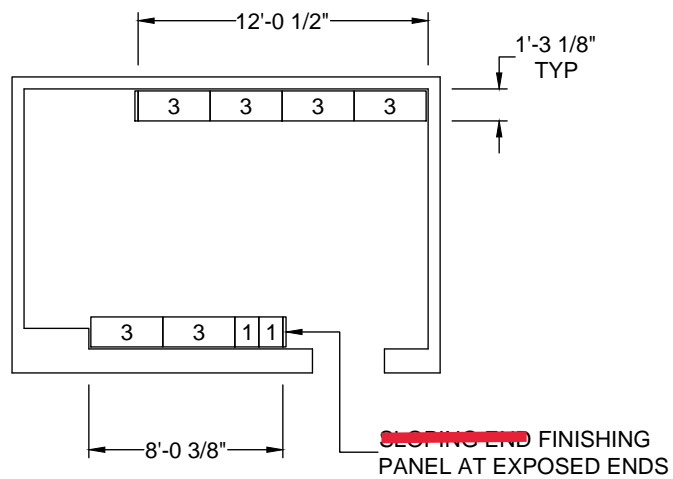


3/A-451

MALE GOWN ROOM (707.01)

(LOC-02) 20 SET-UP LOCKER FRAMES 12" X 15" X 36" S.R.D.T. W/ SLOPING HOOD & 4" Z-BASE

COLOR LOCKER PARTS: _____
 NUMBERING SEQUENCE: _____

PROVIDE PARAMETERS FOR THE NUMBERING.
 - # OF CHARACTERS
 - FONT
 - MATERIAL
 - SUBMIT SAMPLE FOR REVIEW.

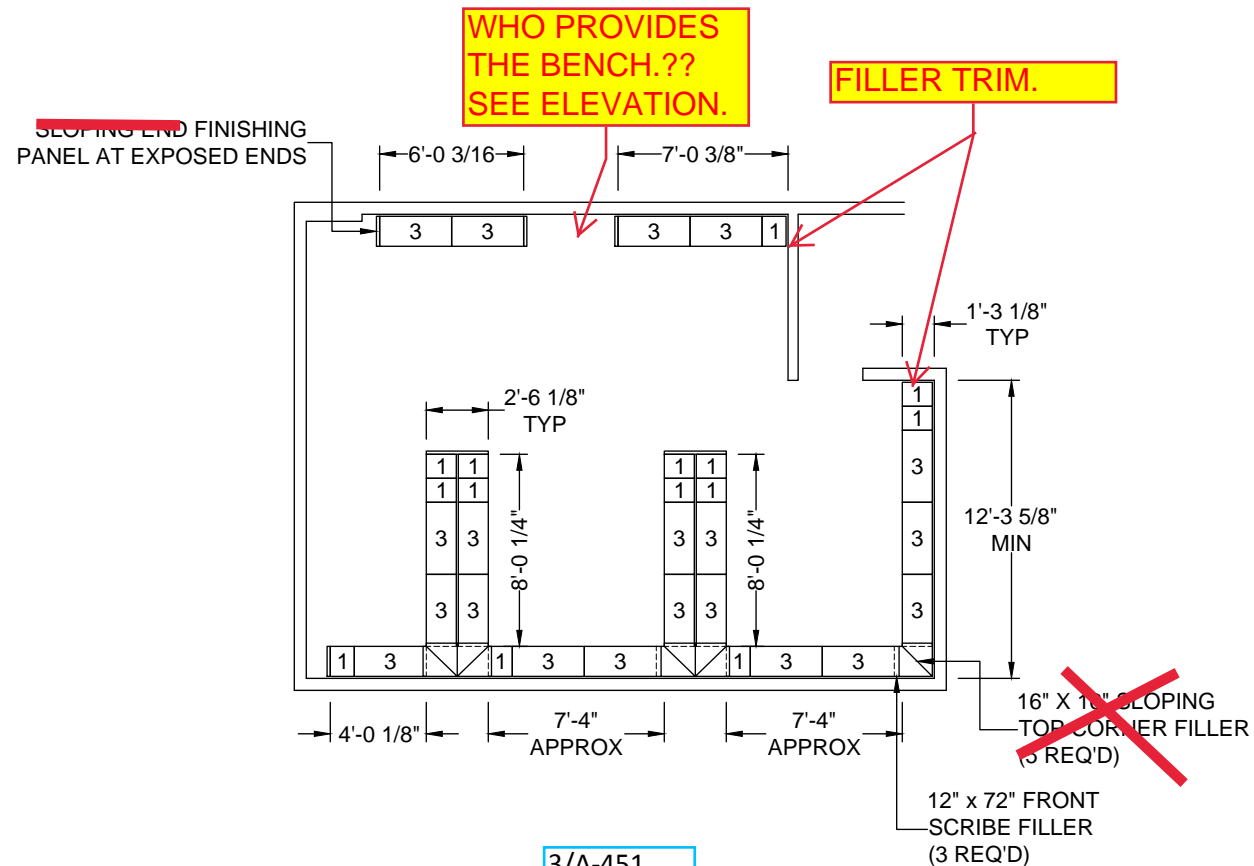

3/A-451


FEMALE GOWN ROOM (707)

(LOC-02) 74 SET-UP LOCKER FRAMES 12" X 15" X 36" S.R.D.T. W/ SLOPING HOOD & 4" Z-BASE

COLOR LOCKER PARTS: _____
 NUMBERING SEQUENCE: _____

Reviewed by
F. J. Sciamè Construction
 04/04/2017
 105113-001.001-02

ARCHITECT APPROVAL		
APPROVED AS NOTED	INITIAL	DATE
REVISION AS NOTED		
RE-SUBMIT		
NUMBER SEQUENCE ATTACHED		
COLOR PLAN ATTACHED		
FINAL APPROVAL	INITIAL	DATE
CHECKED BY	INITIAL	DATE
<small>NOTICE: THIS DOCUMENT IS CONFIDENTIAL AND PROPRIETARY. NO PART OF THIS DOCUMENT MAY BE DISCLOSED IN ANY MANNER TO A THIRD PARTY WITHOUT THE PRIOR WRITTEN CONSENT OF LYON L.L.C.</small>		
PROJECT: CUNY CITY TECH ACADEMIC BUILDING		
LOCATION: BROOKLYN, NY		
ARCHITECT:		
CONTRACTOR: NU-TECH FURNISHINGS INC ISLANDIA, NY		
DRAWN BY: JZ	DATE: JULY 19, 2016	
 <small>LYON, L.L.C. P.O. BOX 671 AURORA, IL 60507-0671 P: 800-323-0082</small>		
REVISED DATES	PRE-CHECK DATES	
9/8 2016	3/7 2017	
REVISED BY: JZ	CHECKED BY: -	
DWG NO: 16253	ORDER NO: 710165	

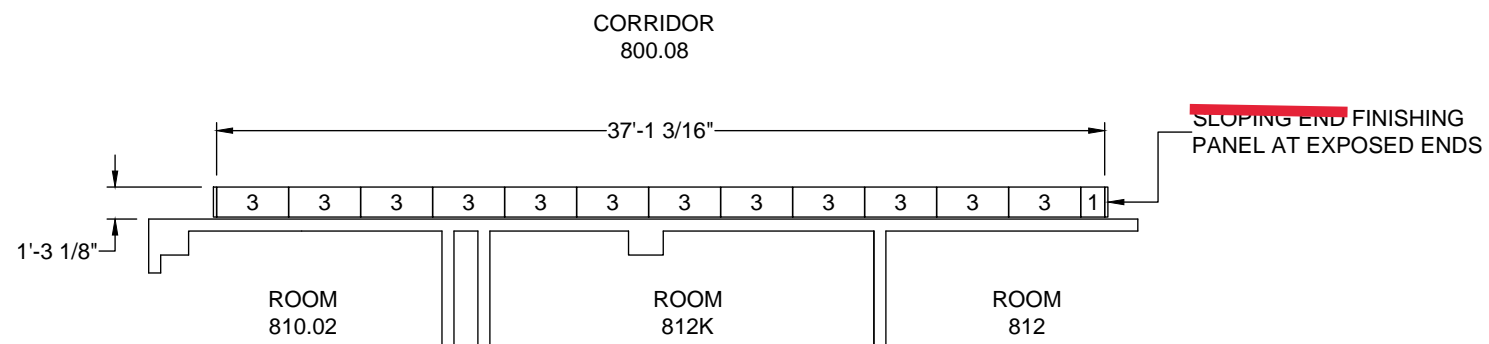

A-124

CORRIDOR LOCKERS (800.08)
 (LOC-02) 37 SET-UP LOCKER FRAMES 12" X 15" X 36" S.R.D.T. W/ SLOPING HOOD & 4" Z-BASE

COLOR LOCKER PARTS: _____
 NUMBERING SEQUENCE: _____

PROVIDE PARAMETERS FOR THE NUMBERING.
 -# OF CHARACTERS
 - FONT
 - MATERIAL
 -SUMBIT SAMPLE FOR REVIEW.

Reviewed by
F. J. Sciamè Construction
 04/04/2017
 105113-001.001-02

ARCHITECT APPROVAL		
APPROVED AS NOTED	INITIAL	DATE
REVISION AS NOTED		
RE-SUBMIT		
NUMBER SEQUENCE ATTACHED		
COLOR PLAN ATTACHED		
FINAL APPROVAL	INITIAL	DATE
CHECKED BY	INITIAL	DATE
<small>NOTICE: THIS DOCUMENT IS CONFIDENTIAL AND PROPRIETARY. NO PART OF THIS DOCUMENT MAY BE DISCLOSED IN ANY MANNER TO A THIRD PARTY WITHOUT THE PRIOR WRITTEN CONSENT OF LYON L.L.C.</small>		
PROJECT: CUNY CITY TECH ACADEMIC BUILDING		
LOCATION: BROOKLYN, NY		
ARCHITECT:		
CONTRACTOR: NU-TECH FURNISHINGS INC ISLANDIA, NY		
DRAWN BY: JZ	DATE: JULY 19, 2016	
LYON <small>LYON, L.L.C. P.O. BOX 671 AURORA, IL 60507-0671 P: 800-323-0082 www.lyonworkspace.com</small>		
REVISED DATES	PRE-CHECK DATES	
3/7 2017		
REVISED BY: JZ	CHECKED BY: -	
DWG NO: 16253	ORDER NO: 710165	

1. Lyon is an approved manufacturer and they are following the specification and return submittal dated 2/22/17
2. The ventilation type is custom for the lockers, at this time there are no photos available
3. CRG is the specified Club Resource Group company
4. CRG does not provide product data, they only provide attached drawing (page 18)
5. Locker color samples were previously submitted
6. Bench hard color sample to be submitted in the future
7. Lyon LEED data submitted and approved previously, CRG LEED data to be submitted in a separate submittal
8. Door swing is right hinge, this is an industry standard and cannot be changed
9. Bench size of 9' and 3'6" does not exist from the CRG, 8' and 4' benches are provided

1. REFER TO PREVIOUS AND CURRENT COMMENTS ATTACHED. (SEE DWGS.)
2. APPROVAL IS CONTINGENT ON VERIFICATION OF COMPLIANCE WITH THE LEED REQUIREMENTS AND APPROVAL OF ALL ADDRESSING ALL COMMENTS IN THE PREVIOUS AND CURRENT LOCKER SHOP DWG SUBMISSION.
3. FOR LOCKERS IN LOCKER ROOMS: LL206, LL208, LL209, LL210, LL211, 707 AND 707.01:
 - a. BODY AND FRAME= SEPIA BROWN-8014-9A
 - b. LOCKER DOOR= WHITEWASH -WH395-11.
4. FOR LOCKERS IN COORIDORS, LOUNGES AND VESTIBULES: WHITEWASH -WH395-11 FOR BODY, FRAME AND DOORS.
5. DELETE OPTION FOR SLOPED HOOD AND PROVIDE CREDIT FOR MATERIAL AND LABOR.
6. COMPLY WITH LEED CRITERIA AS PER SPECS.
7. PROVIDE SAMPLE AND PARAMETERS FOR THE NUMBERING PLATE.
 - a. # OF CHARACTERS - FONT AND MATERIAL
 - b. SUMBIT NUMBER PLATE SAMPLE FOR REVIEW.